

11-DEC-2012 14:37

Chad. Havens

TIME\$\$\$ 006043ST18-1A
8825Full.pen

R:\07400004\006043\DGNS\As Bullets\DGNS\006043ST18-1A.dgn

STATE

GA


PROJECT NUMBER
CSNHS-0006-001043

SHEET NO.

119

TOTAL SHEETS
668

AS-BUILT PLANS 12/12/12

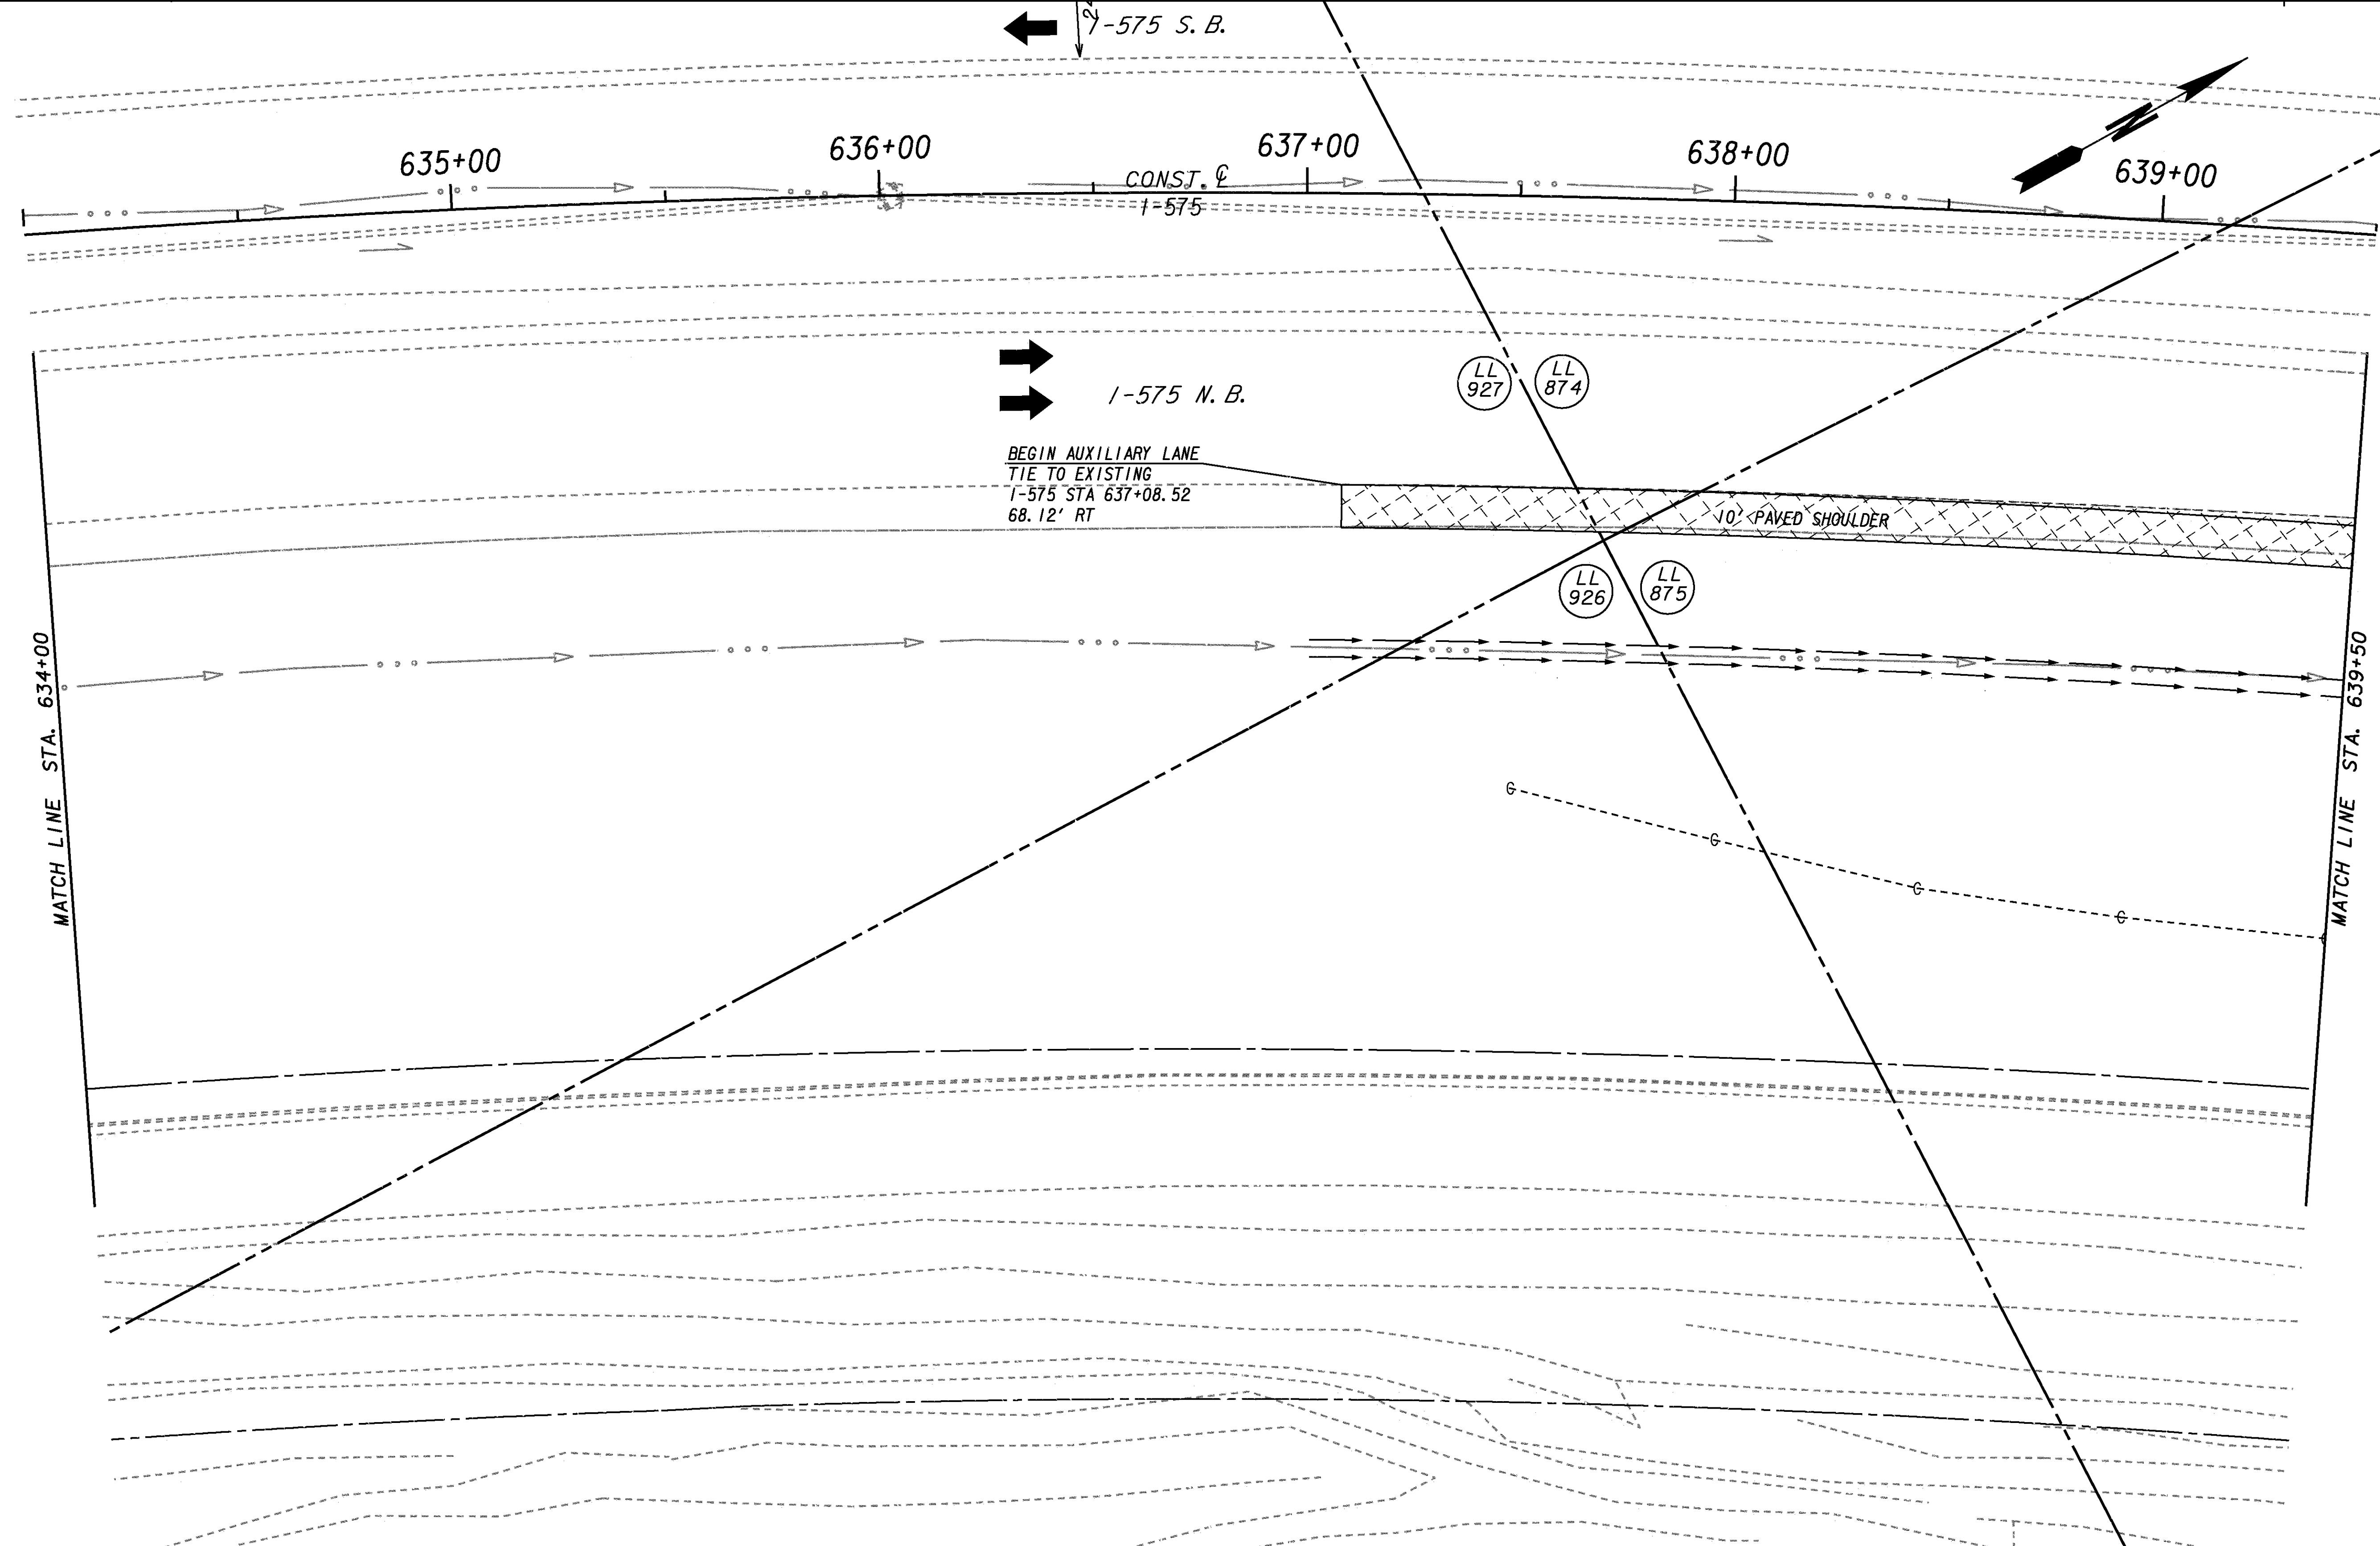

LEGEND

PAVEMENT REMOVAL	[Symbol: Hatched area]
TEMPORARY CONSTRUCTION PAVEMENT	[Symbol: Dashed hatching]
PERMANENT CONSTRUCTION	[Symbol: Cross-hatching]
CONCRETE MEDIAN CONSTRUCTION	[Symbol: Diagonal hatching]
MILL & OVERLAY CONSTRUCTION	[Symbol: Horizontal hatching]
OPEN LANES OF TRAFFIC	[Symbol: Arrow pointing right]

STAGE 1 PHASE 1

THE
LPA
GROUP
TRANSPORTATION CONSULTANTS
3595 ENGINEERING DRIVE
NORCROSS, GEORGIA 30092
(770) 263-9118

REVISION DATES

STATE OF GEORGIA
DEPARTMENT OF TRANSPORTATION
OFFICE: INNOVATIVE PROGRAM DELIVERY
CONSTRUCTION STAGING PLAN
I-575 NB AUXILIARY LANE
BEGIN CONSTR. TO STA. 639+50

DRAWING NO.
19-018